2025 SANITARY SEWER LINING PROJECT CITY OF SWISHER, IOWA

CONTRACTOR'S BID DATE: Monday, January 13, 2023 @ 1:00 P.M.

PLACE FOR CONTRACTORS

TO SUBMIT BIDS: City of Swisher City Hall

66 2nd Street SW Swisher, Iowa 52338

ADDENDUM NO.2

January 9, 2025

TO ALL PLANHOLDERS:

The following changes, clarifications, additions, and/or deletions are hereby made a part of the contract documents for the above-referenced project, as fully and completely as if the same were fully set forth therein. All Bidders submitting a Bid on the above Contract shall carefully read this Addendum and give it consideration in the preparation of their Bid.

This Addendum No. 2 consists of the following:

- Addendum No. 2 (pages ADN1-2)
- Plan Sheet C.01 Estimated Project Quantities and Reference Information

General:

1. Please return Bids to the City of Swisher as noted above and on the cover sheet of the Proposal. Use the provided Proposal Form and acknowledge receipt of this Addendum. Bids provided on other forms will not be accepted.


PLANS:

1. REFER TO SHEET C.01

a. **REVISE** Estimated Project Quantities, Items 8 and 9, to each be 30 SY as was shown on the original bid documents.

All bidders shall acknowledge receipt and acceptance of Addendum No. 1 by signing in the space provided on the Bid Form. Bids submitted without Addendum No. 1 being acknowledged will be considered non-responsive.

January 9, 2025 ADN1 - 1

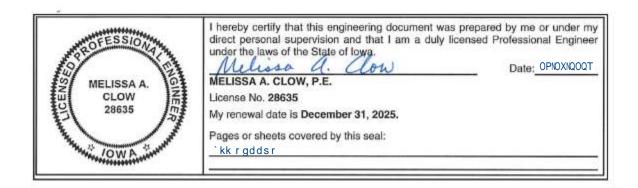

Swisher, Iowa ADDENDUM #2

MELISSA CLOW, PE HR GREEN, INC. 8710 EARHART LANE CEDAR RAPIDS, IOWA 52404 PHONE: (319) 841-4000

END OF ADDENDUM #2

January 9, 2025 ADN1 - 2


ESTIMATED PROJECT QUANTITIES									
Item No.	Item Code	ltem	Unit	Total As Built Qty.					
1	4050-A-2	ADDITIONAL SEWER CLEANING	HOUR	40					
2	4050-C-1	CIPP MAIN LINING, 8"	LF	2971					
3	4050-C-2	BUILDING SANITARY SEWER SERVICE REINSTATEMENT	EΑ	43					
4	4050-C-3	CIPP END SEAL, 8"	EA	20					
- 5	4050-E-1	CIPP SERVICE PIPE, CONNECTION, 4"	EA	4 .					
6	4050-H-1	SPOT REPAIRS BY PIPE REPLACEMENT, 8"	EA	2 /2					
7	4050-H-2	SPOT REPAIRS BY PIPE REPLACEMENT, 8"	LF	20 20					
8	7040-H	PAVEMENT REMOVAL, SEAL COAT	SY	30					
9	7999-1	GRANULAR SURFACING ON ROAD, CL A CR STONE, 6"	SY	(30)					
10	8030-A	TEMPORARY TRAFFIC CONTROL	LS						
11	11,020-A	MOBILIZATION	LS	1					

– N/IN() I	нтем соон	ITEM DESCRIPTION						
1	4050-A-2	ADDITIONAL SEWER CLEANING						
	1550112		ER CLEANING, ROOT CUTTING, DEPOSIT CUTTING, AND REMOVING.					
			COSTS FOR ALL DEBRIS REMOVED FROM SEWER. AND POST CLEANING CCTV					
		INSPECTION FOR ENGINEER REVIEW.						
		B. PRE-REHABILITATION CLEANING AND INSPECTION	WAS PREVIOUSLY COMPLETED. REPORTS AND VIDEO WILL BE MADE AVAILABL					
		TO THE CONTRACTOR.						
2	4050-C-1	CIPP MAIN LINING, 8"						
_		A BYPASS PUMPING IS REQUIRED AND SHALL BE INC	CIDENTAL TO THIS ITEM.					
		B. PIPE LINING IS TO COMMECE ONLY AFTER THE CO	IMPLETION AND APPROVAL OF SEWER CLEANING AND SPOT REPAIRS.					
3	4050-C-2	BUILDING SANITARY SEWER SERVICE REINSTATEMEN	Т					
Ť	4000 0 2		CE LINES FROM PRE-REHABILITATION CCTV INSPECTIONS, RUNNING WATER					
			NS, OR DYE TESTING AS NECESSARY TO CONFIRM STATUS.					
		B. ITEM INCLUDES CONTRACTOR COORDINATION W						
4	4050-C-3	CIPP END SEAL. 8"						
-	4030-0-3	A. FURNISH END SEAL AND INSTALLATION.						
		A. I GIVINGITE NO DEPEARO INCIDENCIA.						
5	4050-E-1	CIPP SERVICE PIPE. CONNECTION, 4"						
		A. FURNISH AND PLACE SERVICE CONNECTION LINER 6" (MIN.) UP LATERAL.						
6	4050-H-1	SPOT REPAIRS BY PIPE REPLACEMENT, 8"						
	1002111	A REFER TO TABULATION FOR LOCATIONS.						
		B. THIS ITEM TO BE MEASURED BY EACH SPOT REPAIR.						
		C, UNCOVERING AND REMOVING EXISTING PIPE AND FURNISHING AND PLACING BEDDING AND BACKFILL MATERIAL.						
		D. BEDDING SHALL BE CLASS R-2 PER SUDAS FIGURE 3010.102. BACKFILL ABOVE TRENCH BEDDING WITH GRANULAR BACKFILL						
		UNDERNEATH ALL ROADWAY PAVEMENT AND DRI	VES.					
7	4050-H-2	SPOT REPAIRS BY PIPE REPLACEMENT, 8"						
	1002112	A REFER TO TABULATION FOR LOCATIONS.						
		B. THIS ITEM TO BE MEASURED BY LINEAR FEET OF REPLACEMENT PIPE.						
		C. FURNISH AND INSTALL REPLACEMENT PIPE AND CONNECTIONS.						
		D. REPAIR MATERIAL TO MEET THE REQUIREMENTS	OF SUDAS SECTION 4010.2.01-A. COMPLY WITH ASTM D 3034, SDR 26,					
8	7040-H	PAVEMENT REMOVAL, SEAL COAT						
	7000 4	OR WILL AR OLD FACING OUR ROLD OF A OR OTONIC OF						
9	7999-1	GRANULAR SURFACING ON ROAD, CL A CR STONE, 6						
10	8030-A	TEMPORARY TRAFFIC CONTROL						
		A TRAFFIC CONTROL SHALL CONSIST OF SUDAS ST	ANDARD FIGURES 6030.103, 6030.104, AND 8030.116.					
			INT EDITION OF THE MANUAL ON UNIFORM TRAFFIC CONTROL DEVICES (MUTCO					
			VORKING HOURS OR WHEN WORKERS ARE NOT PRESENT.					
		D. ALL OPEN EXCAVATIONS SHALL BE SURROUNDED						
			AT LEAST ONE OPEN LANE OF TRAFFIC DURING SEWER CLEANING AND LINING					
			TE A ROAD CLOSURE, USE SUDAS STANDARD FIGURE 8030.116.					
		F. CONTRACTOR TO NOTIFY ENGINEER AND OWNER CONSTRUCTION.	R(S) ONE (1) WEEK PRIOR TO CHANGES IN TRAFFIC PATTERNS DURING					
			CIENTLY WEIGHTED TO PREVENT MOVEMENT BY NATURAL FORCES.					
			CIENTLY WEIGHTED TO PREVENT WOVEMENT BY NATURAL FORCES. 'RESPONSE IS REQUIRED, THE CONTRACTOR SHALL MAKE ALL REASONABLE.					
		ACCOMMODATIONS TO NOT HINDER THE RESPON						
			NERS AT LEAST 48 HOURS NOTICE TO AVOID ACCESSIBLITY CONFLICTS.					
		MOBILIZATION						

NO. DATE BY

1. 1/8/25 MAC ADDENDUM 01 2. 1/9/25 MAC ADDENDUM 02

	SANITARY SEWER LINING								
line Number	Sewer Rogion	From	То	Size (In.)	Pipe Material	CTPP Length (LF)	Sanilary Service Reinstatement (EA)	Sewer Cleaning Description	Remarks
55-10	1	76	79	8	CLAY	365.0	5	ROOTS	
SS-11	1	73	76	8	CLAY	365.0	6	ENCRUSTATIONS, ROOTS	
55 12	1	72	73	8	CLAY	210.0	4	ENCRUSTATIONS, ROOTS	
SS 13	1	74	75	8	CLAY	930.0	5	ENCRUSTATIONS	
55-20	2	5.5	59	8	CLAY	362.0	3	FNCRUSTATIONS	
55-21	2	59	62	8	CLAY	214.0	4	ENCRUSTATIONS	
\$5-22	2	59	60	8	CLAY	180.0	3	ENCRUSTATIONS	
55-23	2	66	67	8	CLAY	350.0	6	ENCRUSTATIONS, ROOTS	
SS 30	3	46	51	8	CL/IY/PVC	365.0	5	ROOTS	
55-81	3	50	48	8	CLAY	230.0	2	ROOTS	
				TOTALS:		2971.0	43		

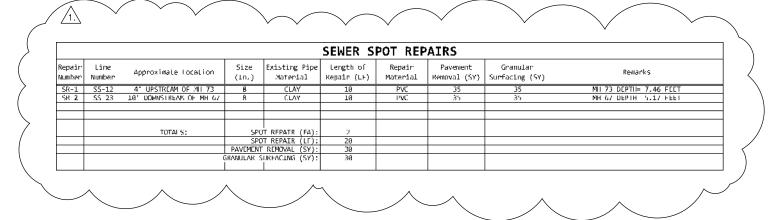

SERVICE PIPE CONNECTIONS						
Line Number	Sewer Region	Fram	Тв	Approximate totation	Tee Liner (EA)	Remarks
SS-11	1	73	76	67' UPSTREAM	1	REMOVE ROOTS
55 12	1	72	73	100.6' UPSTREAM	1	
55-23	2	66	67	314' UPSTREAM	1	REMOVE DEPOSITS
SS-31	2	50	48	125.5' UPSTREAM	1	REMOVE ROOTS
				TOTALS:	4	

GENERAL NOTES

1. THE CITY OF SWISHER DOES NOT HAVE A PUBLIC WATER SUPPLY. CONTRACTORS CAN OBTAIN BULK WATER FROM THE CITY OF CEDAR RAPIDS (319-286-5900) AT 707 J AVE., NE FOR 25 CENTS/75 GALLONS, OR FROM THE CITY OF IOWA CITY (319-356-5066) AT 1200 S. RIVERSIDE DRIVE OR 2401 S. SCOTT BOULEVARD FOR 50 CENTS/100 GALLONS VIA PURCHASED TOKENS.


2. FOR DISPOSAL OF WASTE, THE CONTRACTOR CAN CONTACT EITHER THE CEDAR RAPIDS SOLID WASTE DEPARTMENT (319-286-5897) OR THE IOWA CITY RESOURCE MANAGEMENT DIVISION (319-354-5185).

- NOTIFICATION REQUIREMENTS:

 1. NOTIFY THE CITY OF SWISHER A MINIMUM OF FOUR (4) WORKING DAYS PRIOR TO COMMENCING WORK ON THE PROJECT.
- 2. NOTIFY AFFECTED PROPERTY OWNERS A MINIMUM OF FOUR (4) WORKING DAYS PRIOR TO WORK NEAR THE PROPERTY.
- 3. NOTIFY OWNERS OF SANITARY SEWER SERVICE LATERALS A MINIMUM OF FOUR (4) WORKING DAYS PRIOR TO TEMPORARY SERVICE DISRUPTION. NOTIFY OWNERS AGAIN AT THE BEGINNING AND END OF SERVICE DISRUPTION.

BID SET

DRAWN BY: CPJ BAR IS ONE INCH ON OFFICIAL DRAWINGS. APPROVED: MAC JOB NUMBER: 2404213 IF NOT ONE INCH, ADJUST SCALE ACCORDINGLY CAD DATE: 1/9/2025 10:55:53 AM CAD FILE: J:\2024\2404213\CAD\Dwgs\C\C.01.dwg

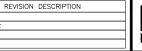



2025 SANITARY SEWER LINING CITY OF SWISHER SWISHER, IA

QUANTITIES AND GENERAL INFORMATION ESTIMATED PROJECT QUANTITIES AND REFERENCE INFORMATION

SHEET NO. C.01